
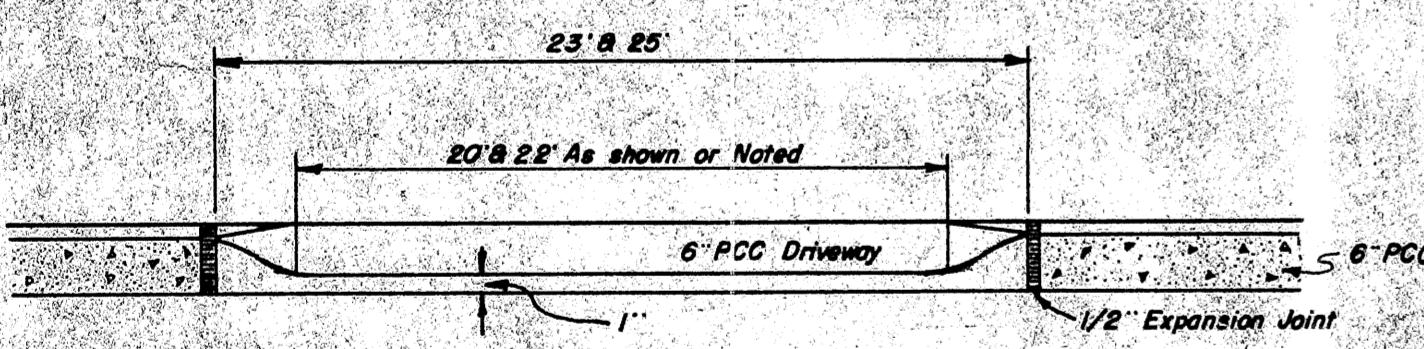
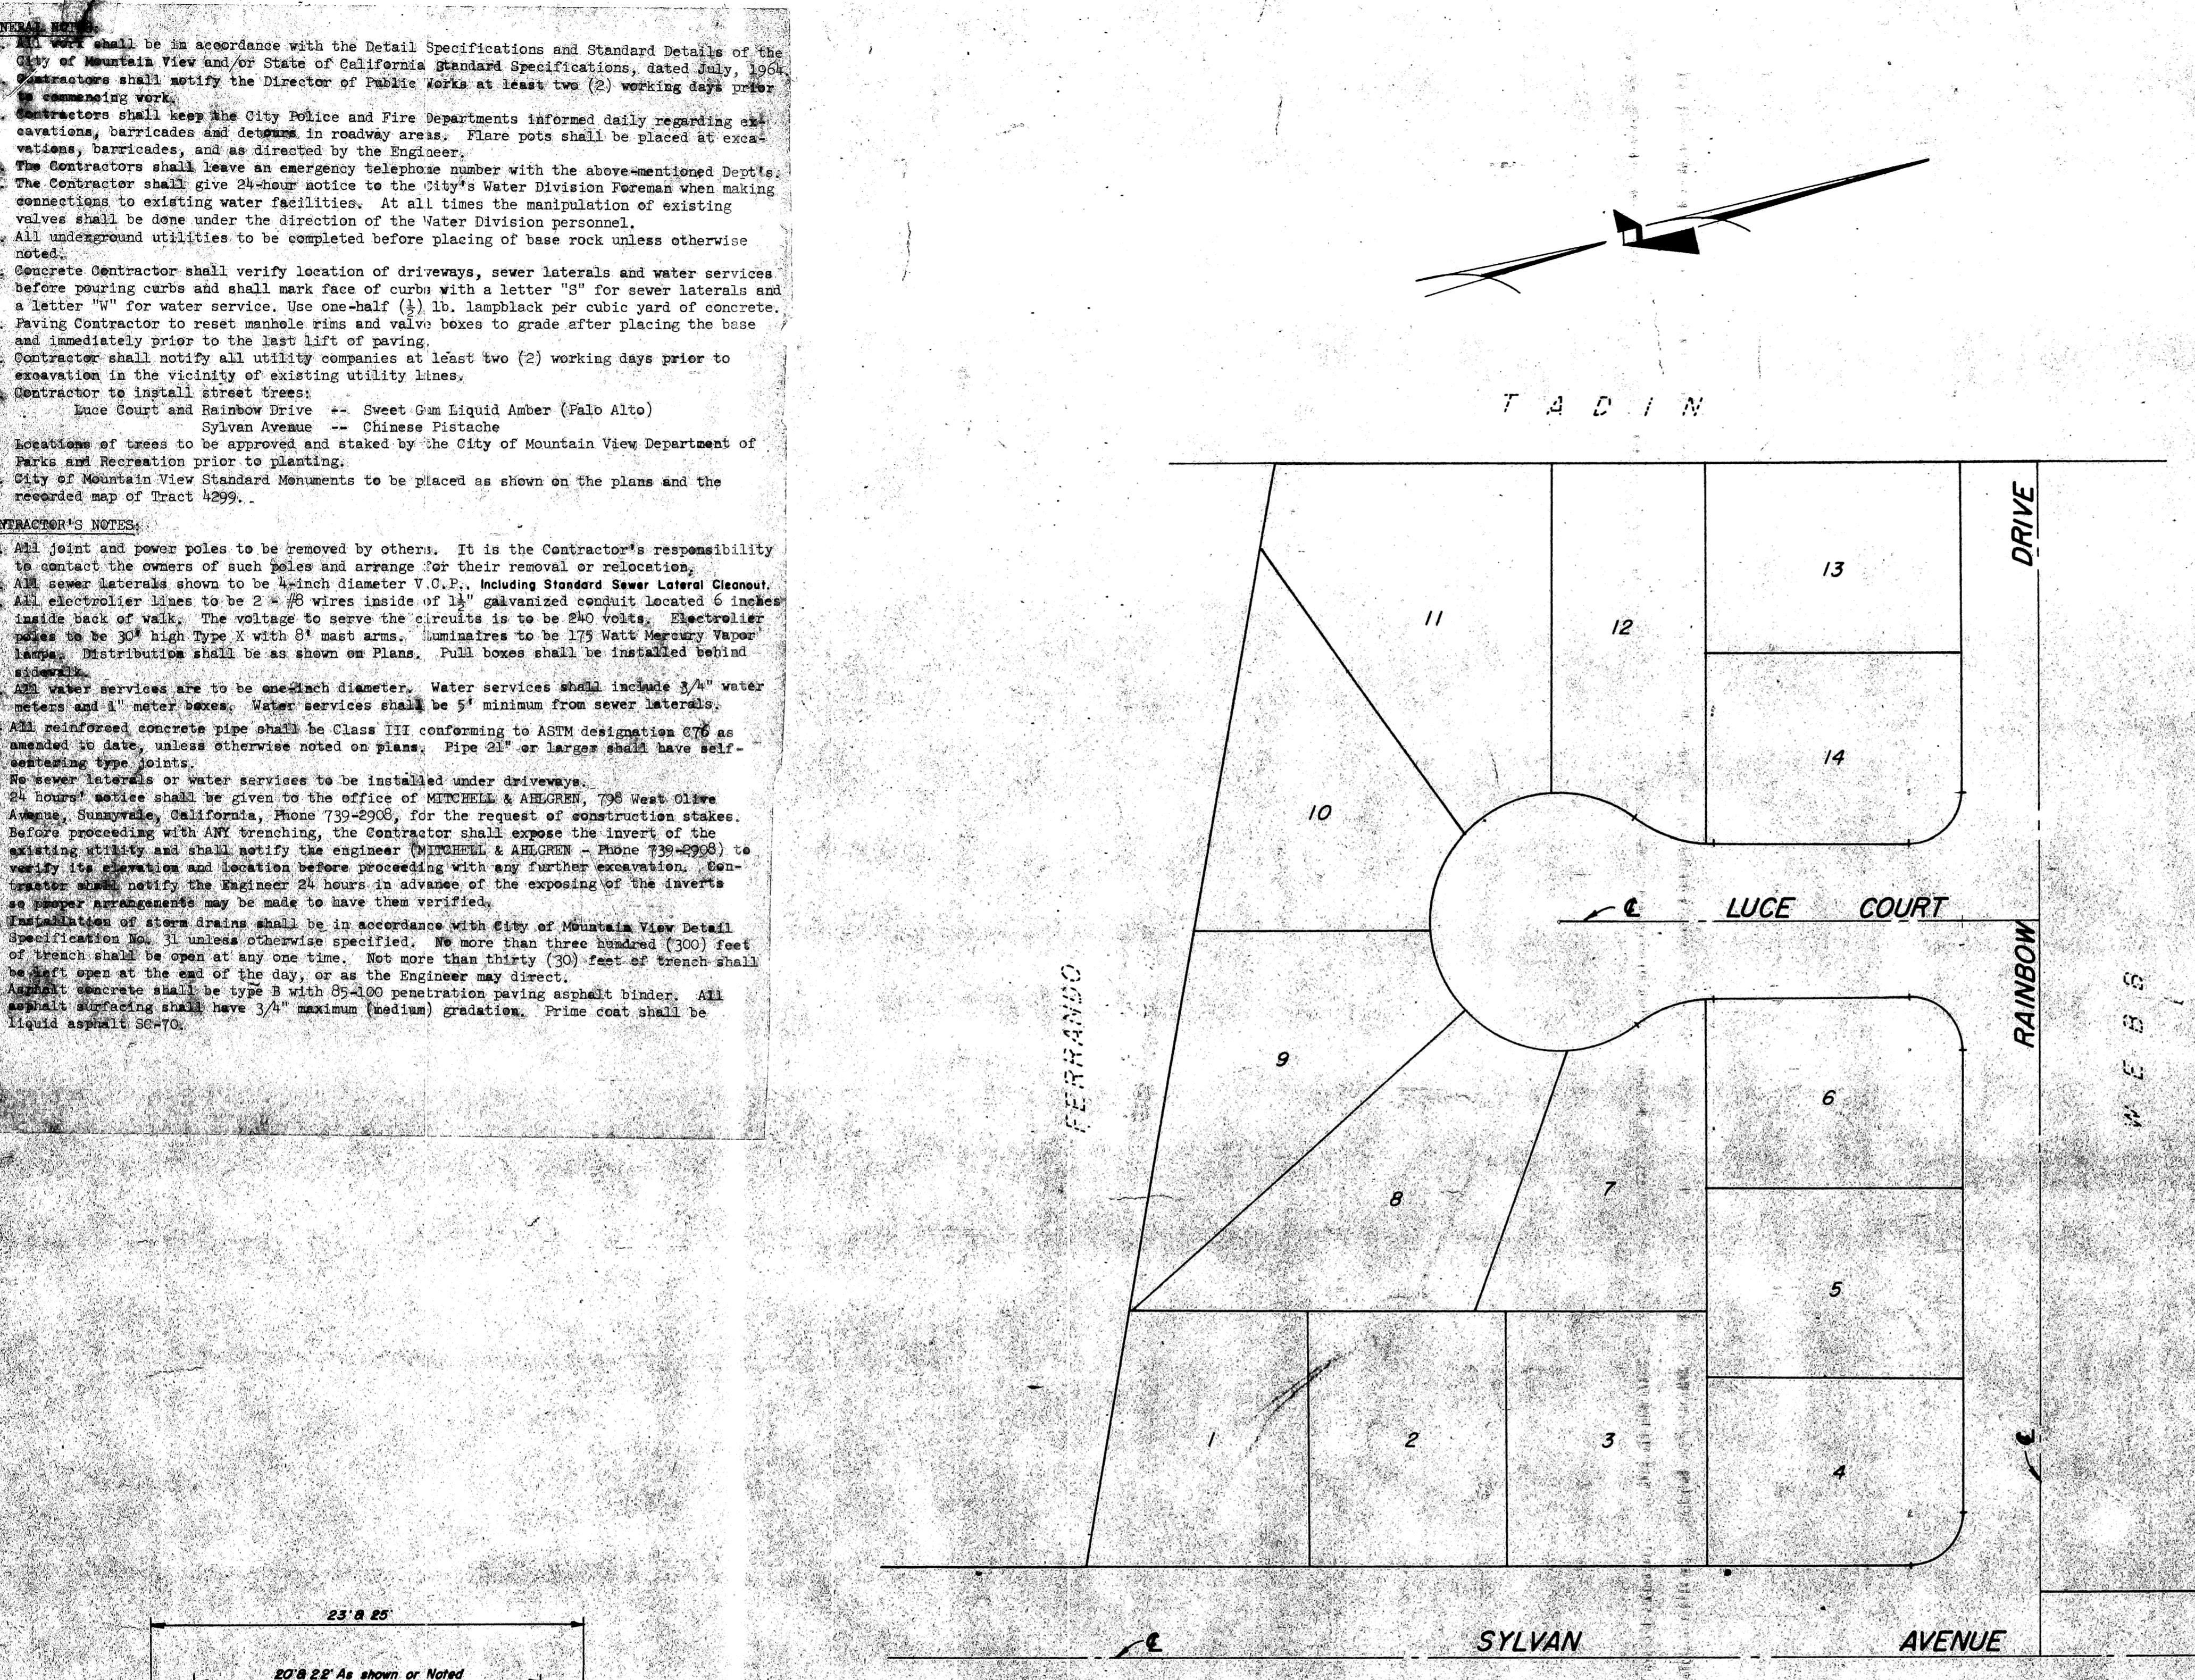


CENTRAL NOTES:

- All work shall be in accordance with the Detail Specifications and Standard Details of the City of Mountain View and/or State of California Standard Specifications, dated July, 1964.
- Contractors shall notify the Director of Public Works at least two (2) working days prior to commencing work.
- Contractors shall keep the City Police and Fire Departments informed daily regarding excavations, barricades and detours in roadway areas. Flare pots shall be placed at excavations, barricades, and as directed by the Engineer.
- The Contractors shall leave an emergency telephone number with the above-mentioned Dept's.
- The Contractor shall give 24-hour notice to the City's Water Division Foreman when making connections to existing water facilities. At all times the manipulation of existing valves shall be done under the direction of the Water Division personnel.
- All underground utilities to be completed before placing of base rock unless otherwise noted.
- Concrete Contractor shall verify location of driveways, sewer laterals and water services before pouring curbs and shall mark face of curbs with a letter "S" for sewer laterals and a letter "W" for water service. Use one-half (½) lb. lampblack per cubic yard of concrete.
- Paving Contractor to reset manhole rims and valve boxes to grade after placing the base and immediately prior to the last lift of paving.
- Contractor shall notify all utility companies at least two (2) working days prior to excavation in the vicinity of existing utility lines.
- Contractor to install street trees:
Luce Court and Rainbow Drive -- Sweet Gum Liquid Amber (Palo Alto)
Sylvan Avenue -- Chinese Pistache
- Locations of trees to be approved and staked by the City of Mountain View Department of Parks and Recreation prior to planting.
- City of Mountain View Standard Monuments to be placed as shown on the plans and the recorded map of Tract 4299.

CONTRACTOR'S NOTES:

- All joint and power poles to be removed by others. It is the Contractor's responsibility to contact the owners of such poles and arrange for their removal or relocation.
- All sewer laterals shown to be 4-inch diameter V.O.P., including Standard Sewer Lateral Cleanout.
- All electrolite lines to be 2 #8 wires inside of 1½" galvanized conduit located 6 inches inside back of walk. The voltage to serve the circuits is to be 240 volts. Electrolite poles to be 30' high Type X with 8' mast arms. Luminaire to be 175 Watt Mercury Vapor lamps. Distribution shall be as shown on Plans. Pull boxes shall be installed behind sidewalk.
- All water services are to be one-inch diameter. Water services shall include 3/4" water meters and 1" meter boxes. Water services shall be 5' minimum from sewer laterals.
- All reinforced concrete pipe shall be Class III conforming to ASTM designation C70 as amended to date, unless otherwise noted on plans. Pipe 21" or larger shall have self-sealing type joints.
- No sewer laterals or water services to be installed under driveways.
- 24 hours' notice shall be given to the office of MITCHELL & AHORNEN, 708 West Olive Avenue, Sunnyvale, California, Phone 739-2908, for the request of construction stakes.
- Before proceeding with ANY trenching, the Contractor shall expose the invert of the existing utility and shall notify the engineer (MITCHELL & AHORNEN - Phone 739-2908) to verify its elevation and location before proceeding with any further excavation. Contractor shall notify the engineer 24 hours in advance of the exposing of the invert so proper arrangements may be made to have them verified.
- Installation of storm drains shall be in accordance with City of Mountain View Detail Specification No. 31 unless otherwise specified. No more than three hundred (300) feet of trench shall be open at any one time. Not more than thirty (30) feet of trench shall be left open at the end of the day, or as the Engineer may direct.
- Asphalt concrete shall be type B with 95-100 penetration paving asphalt binder. All asphalt surface shall have 3/4" maximum (medium) gradation. Prime coat shall be liquid asphalt SC-70.

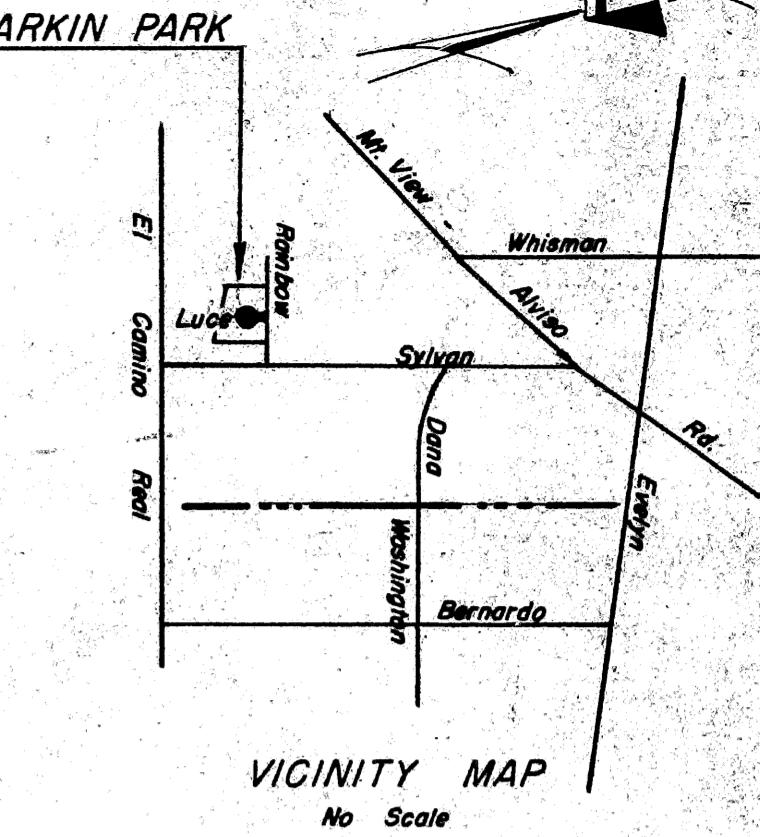

CITY BENCH MARK No. IV-7 - Bronze Disk set in top of the curb at the center of the return located on the Northeast Corner of Sylvan Ave and El Camino Real. ELEV. 133.97
1961 Datum

MICROFILMED OCT70

AS BUILT PLAN
Dated 1-22-68 by [Signature]
Checked by [Signature]

TRACT 4299 -- LARKIN PARK -- UNIT 1	
SECTIONS & DETAILS	
MITCHELL & AHORNEN CONSULTING ENGINEERS TRUSTEES DUE DILIGENCE APPROVALS DATE 1-22-68 BY [Signature]	
APPROVED BY [Signature] RCE 16340 DATE 1-22-68 APPROVED BY [Signature] RCE 11755 ASSISTANT DIRECTOR OF PUBLIC WORKS CITY OF MOUNTAIN VIEW	

STANDARD LEGEND:



EXISTING	PROPOSED	DESCRIPTION	EXISTING	PROPOSED	DESCRIPTION
		Property Line			Curb, Gutter & Sidewalk
		Center Line			Storm Inlet & Inlet Run
		Sanitary Sewer & Manhole			Fire Hydrant
		Water Main			Blow Off or Air Relief
		Storm Sewer & Manhole	E	E	Electrolite, Conduit & Pull Box
		Gate Valve	S.O.S.	S.O.S.	Street Sign & Stop Sign
		Gas Main	O.M.	M	Standard City Monument

FILE NO. 5314-1

- FACE OF CURB CURVE TABLE -

NO	RADIUS	DELTA	LENGTH
1	30.00'	90°00'00"	47.13'
2	60.00'	3°03'39"	3.20'
3	60.00'	33°48'32"	35.40'
4	40.00'	39°55'51"	27.88'
5	40.00'	44°21'58"	30.98'
6	40.00'	44°21'18"	31.20'
7	40.00'	40°07'10"	28.01'
8	40.00'	51°15'45"	35.78'
9	40.00'	33°22'20"	23.30'

PLAN	SURVEYED
	PLOTTED
NOTE BOOK	NOTES CHECKED
NO.	AT TOP OF WAY CHECKED

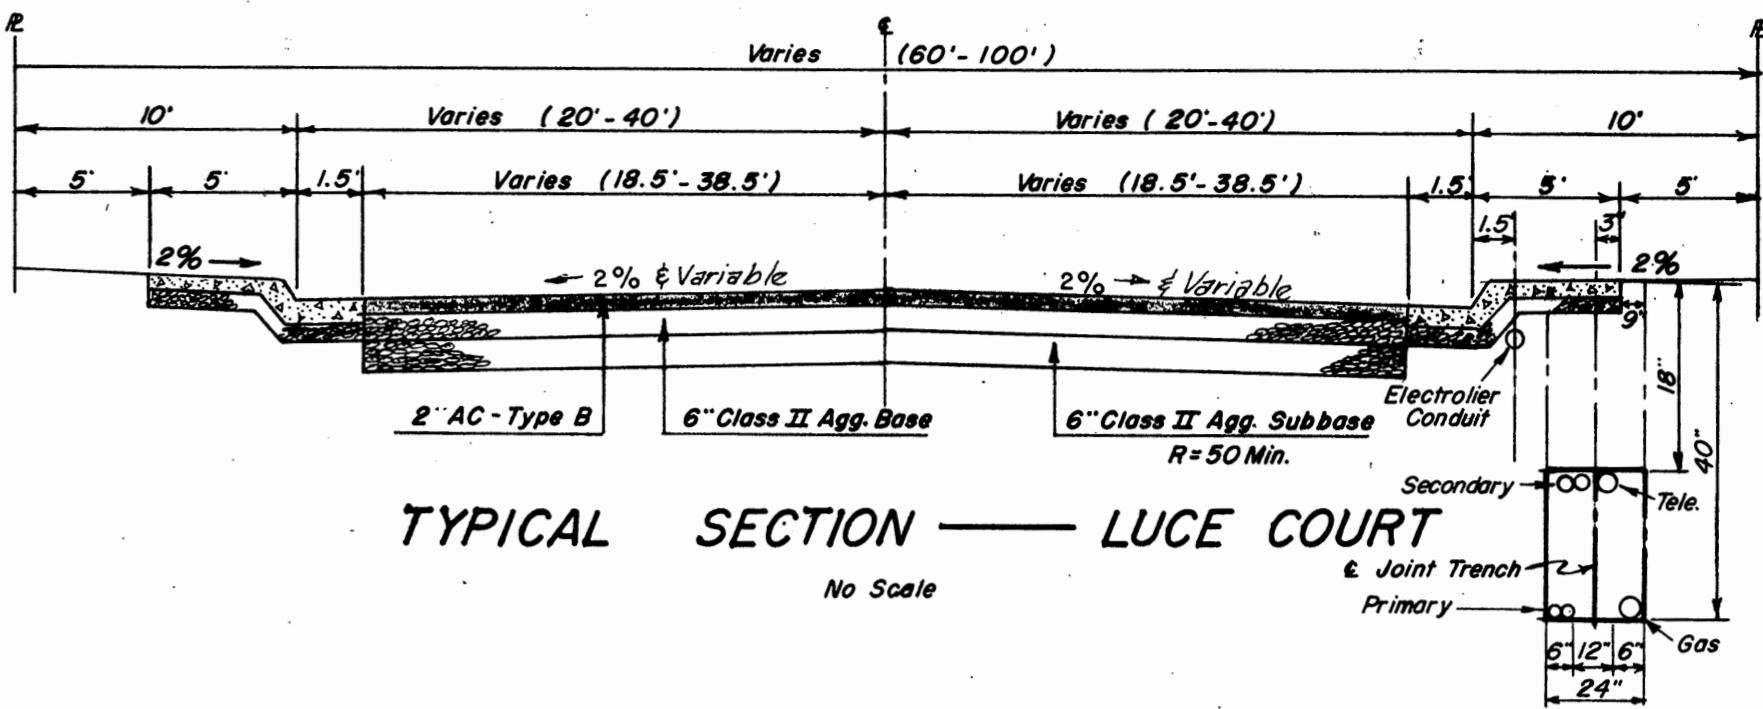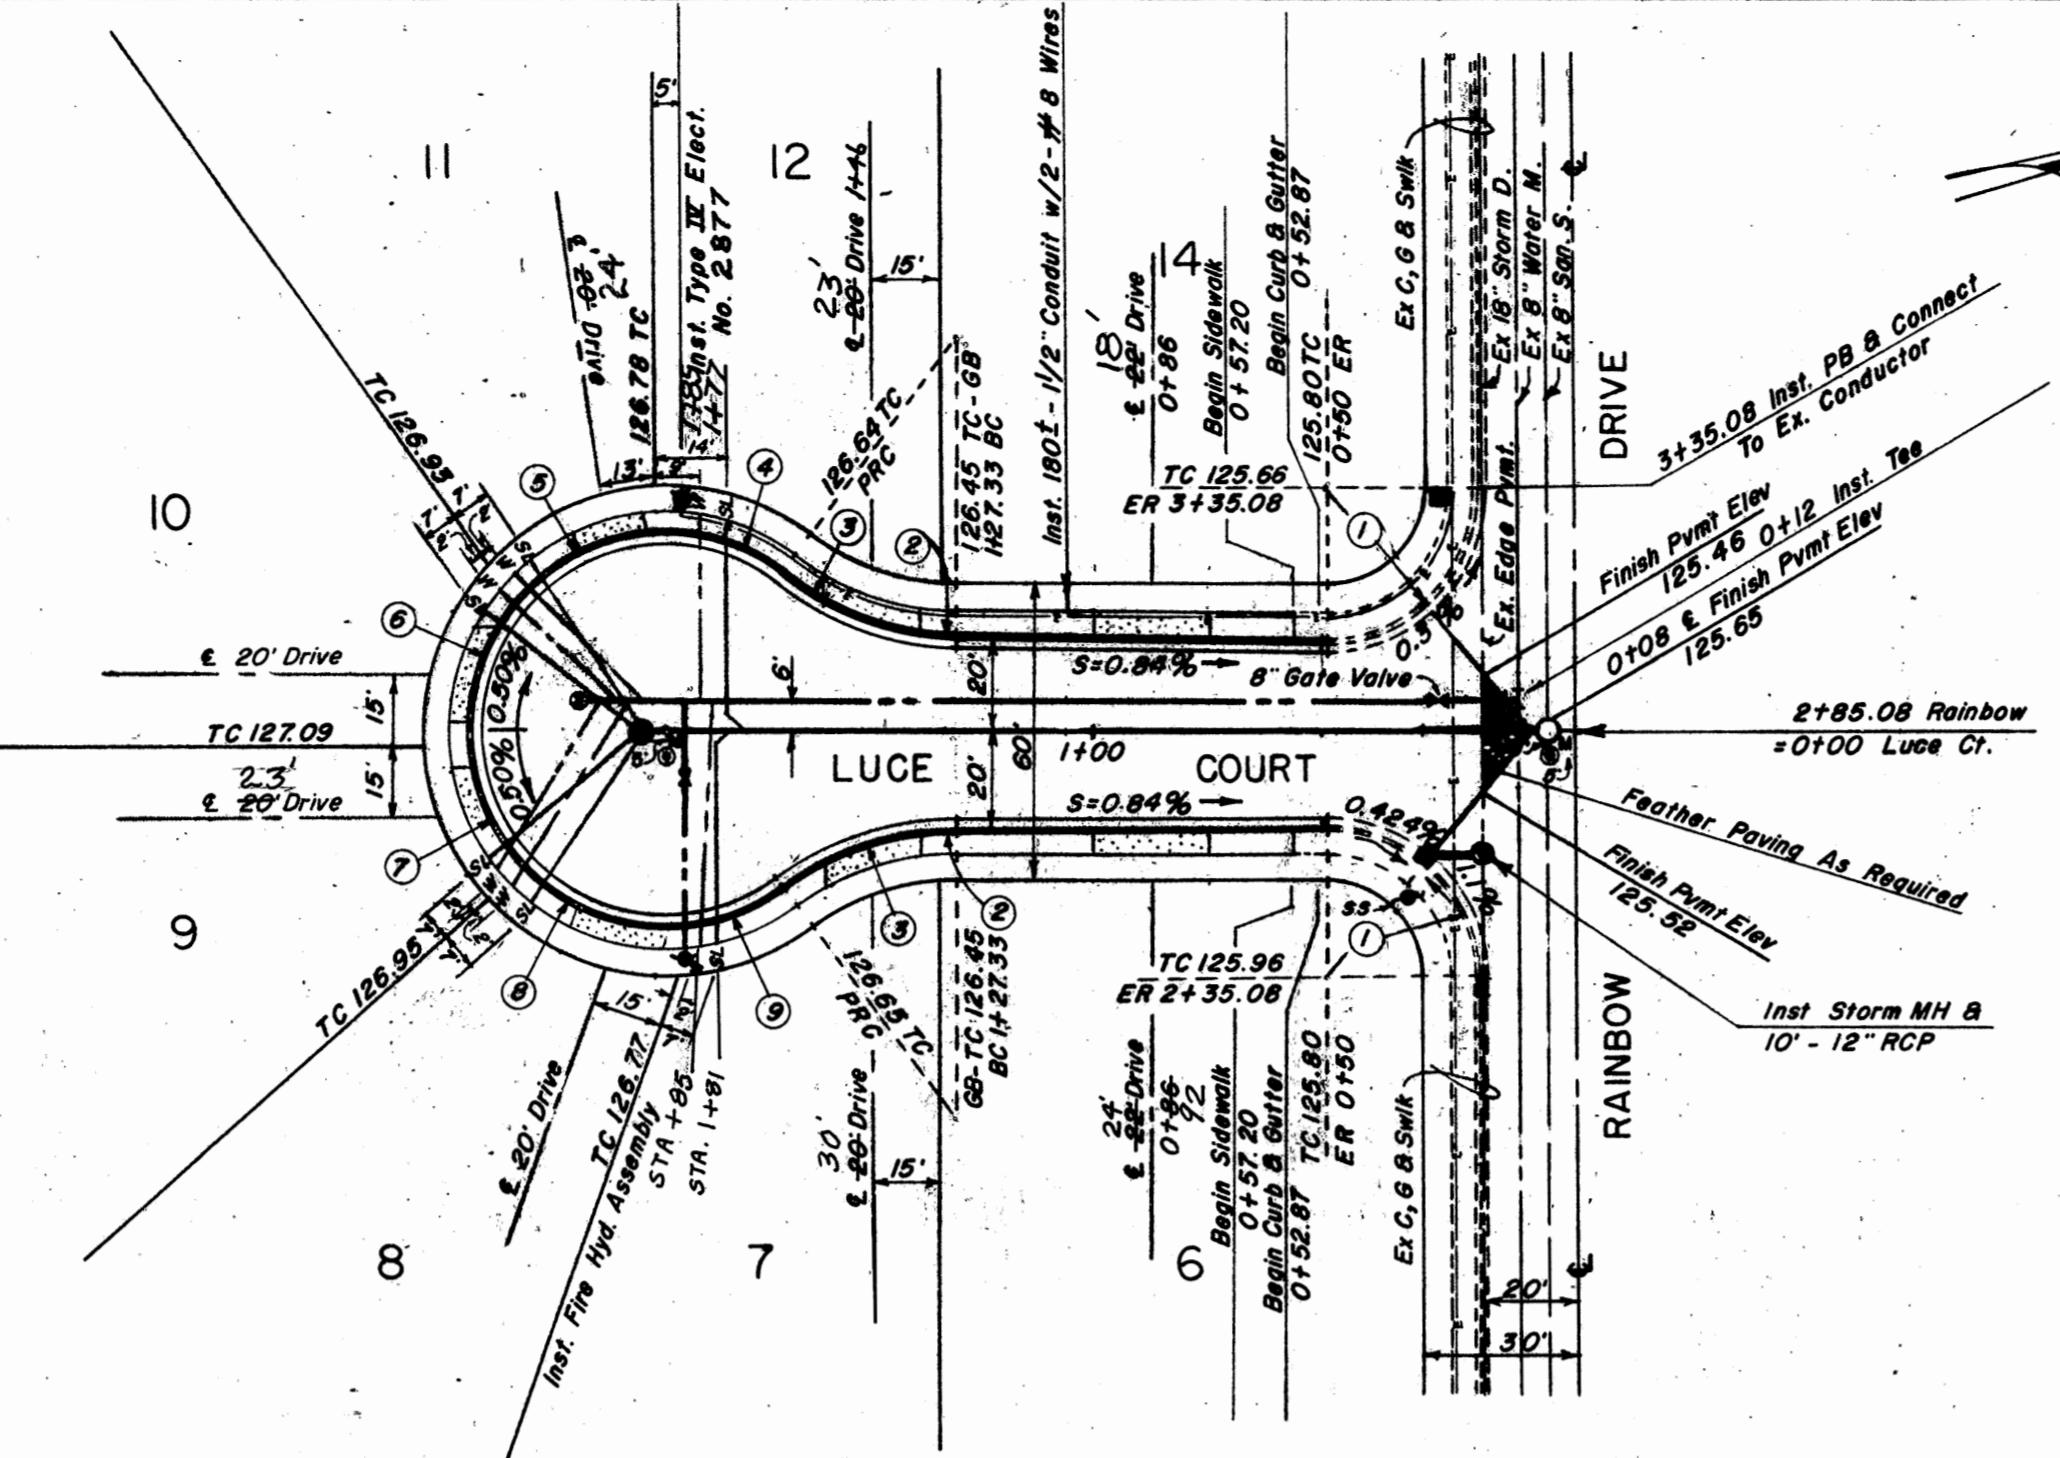


NOTE:

All Improvements Shown On This Plan As Existing
Are To Be Constructed By The Sylvan Ave - El
Camino Real Improvement District Project AD 64-31
The Contractor For This Project Shall Coordinate
All Work With The Contractor For City Project AD 64-31

LUCE COURT

3 2 1 0

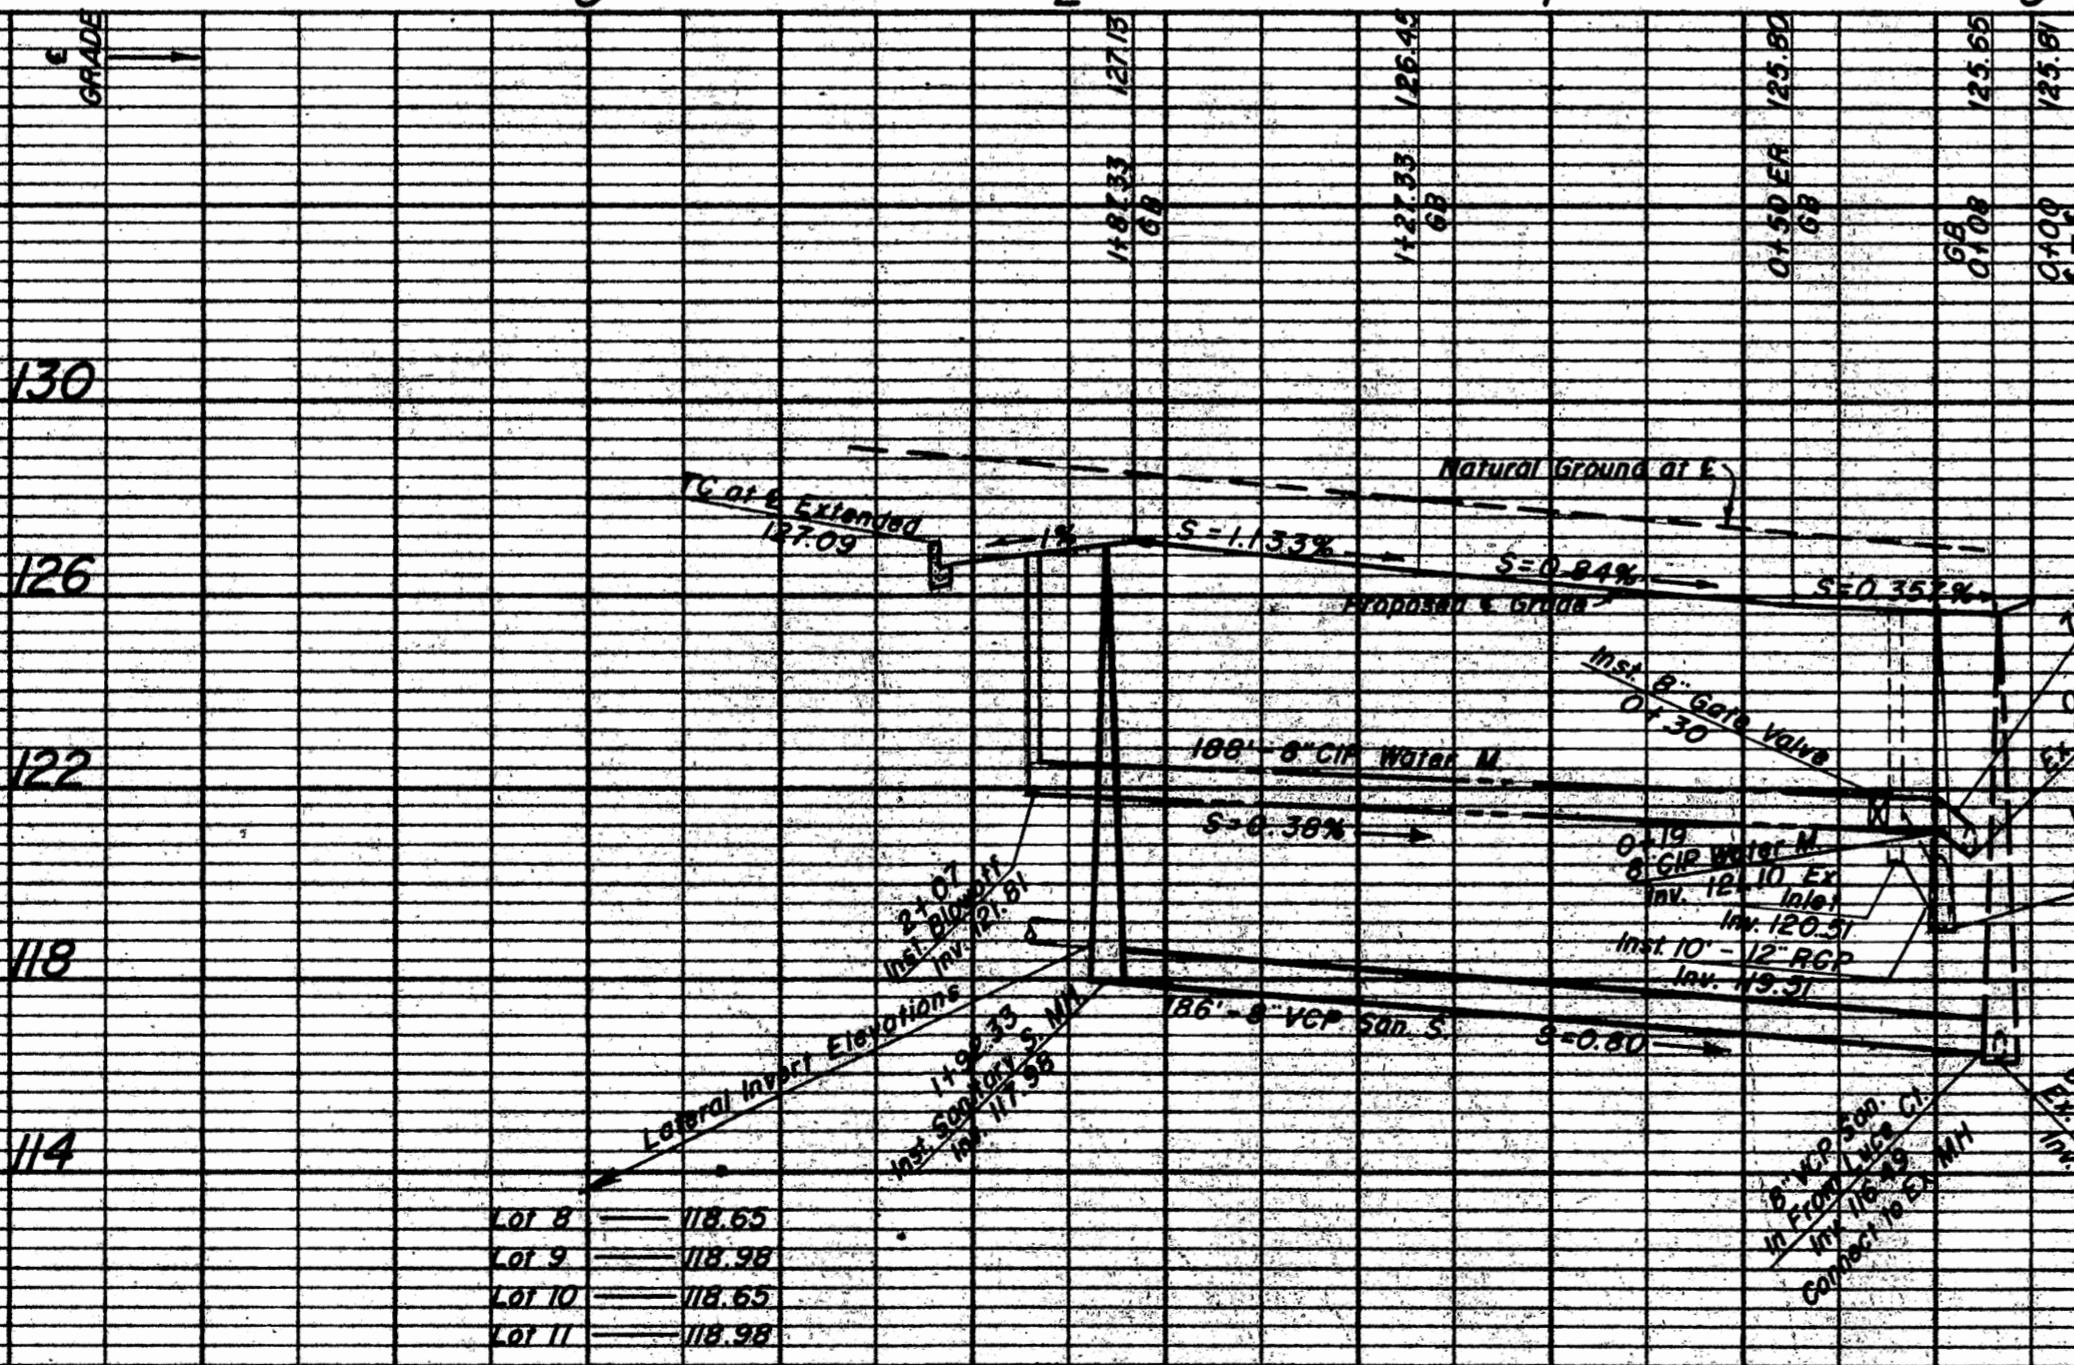

GRADE

MICROFILMED OCT 70

BUILT PLAN

DATE 12-22-68 BY [Signature]

Checked by [Signature] 6-30-69

TRACT 4299 -- LARKIN PARK - UNIT I

STREET IMPROVEMENT PLANS
for LUCE COURT

Mountain View California

MITCHELL & AHLGREN

CONSULTING CIVIL ENGINEERS

798 WEST OLIVE AVENUE • SUNNYVALE • CALIFORNIA • 94086

DESIGNED MLE APPROVED April, 1967 DATE

DRAWN MKW DEXTER D. AHLGREN - RCE 10307 67771 JOB NO.

CHECKED DDA SCALE 1:400 Vert. 1:4 2 OF 2

Approval Recommended Allen Muller Date 5-16-67
Senior Engineer RCE 16340
Approved [Signature] 5/22/67 R.C.E. 16355
Date 5/22/67 Assistant Director of Public Works
City of Mountain View